



These plans are conditionally approved as submitted or noted during plan review and are subject to field inspection. Approved plans must be kept on site and are needed for all inspections. No changes or modifications to these plans. Changes require a revision permit with the revised plans. Trade Permits are required for trade work. e.g. Electrical or Plumbing

DC Water Review - Vahid Bilvardi - 08-30-2017
Structural Review - Jeff Reiss - 08-30-2017
DDOT Review - Tiffany Tenbrook - 08-30-2017
Energy Review - Robert Campbell - 08-30-2017
DOEE SE-SW Review - Nykia Barnes - 08-30-2017

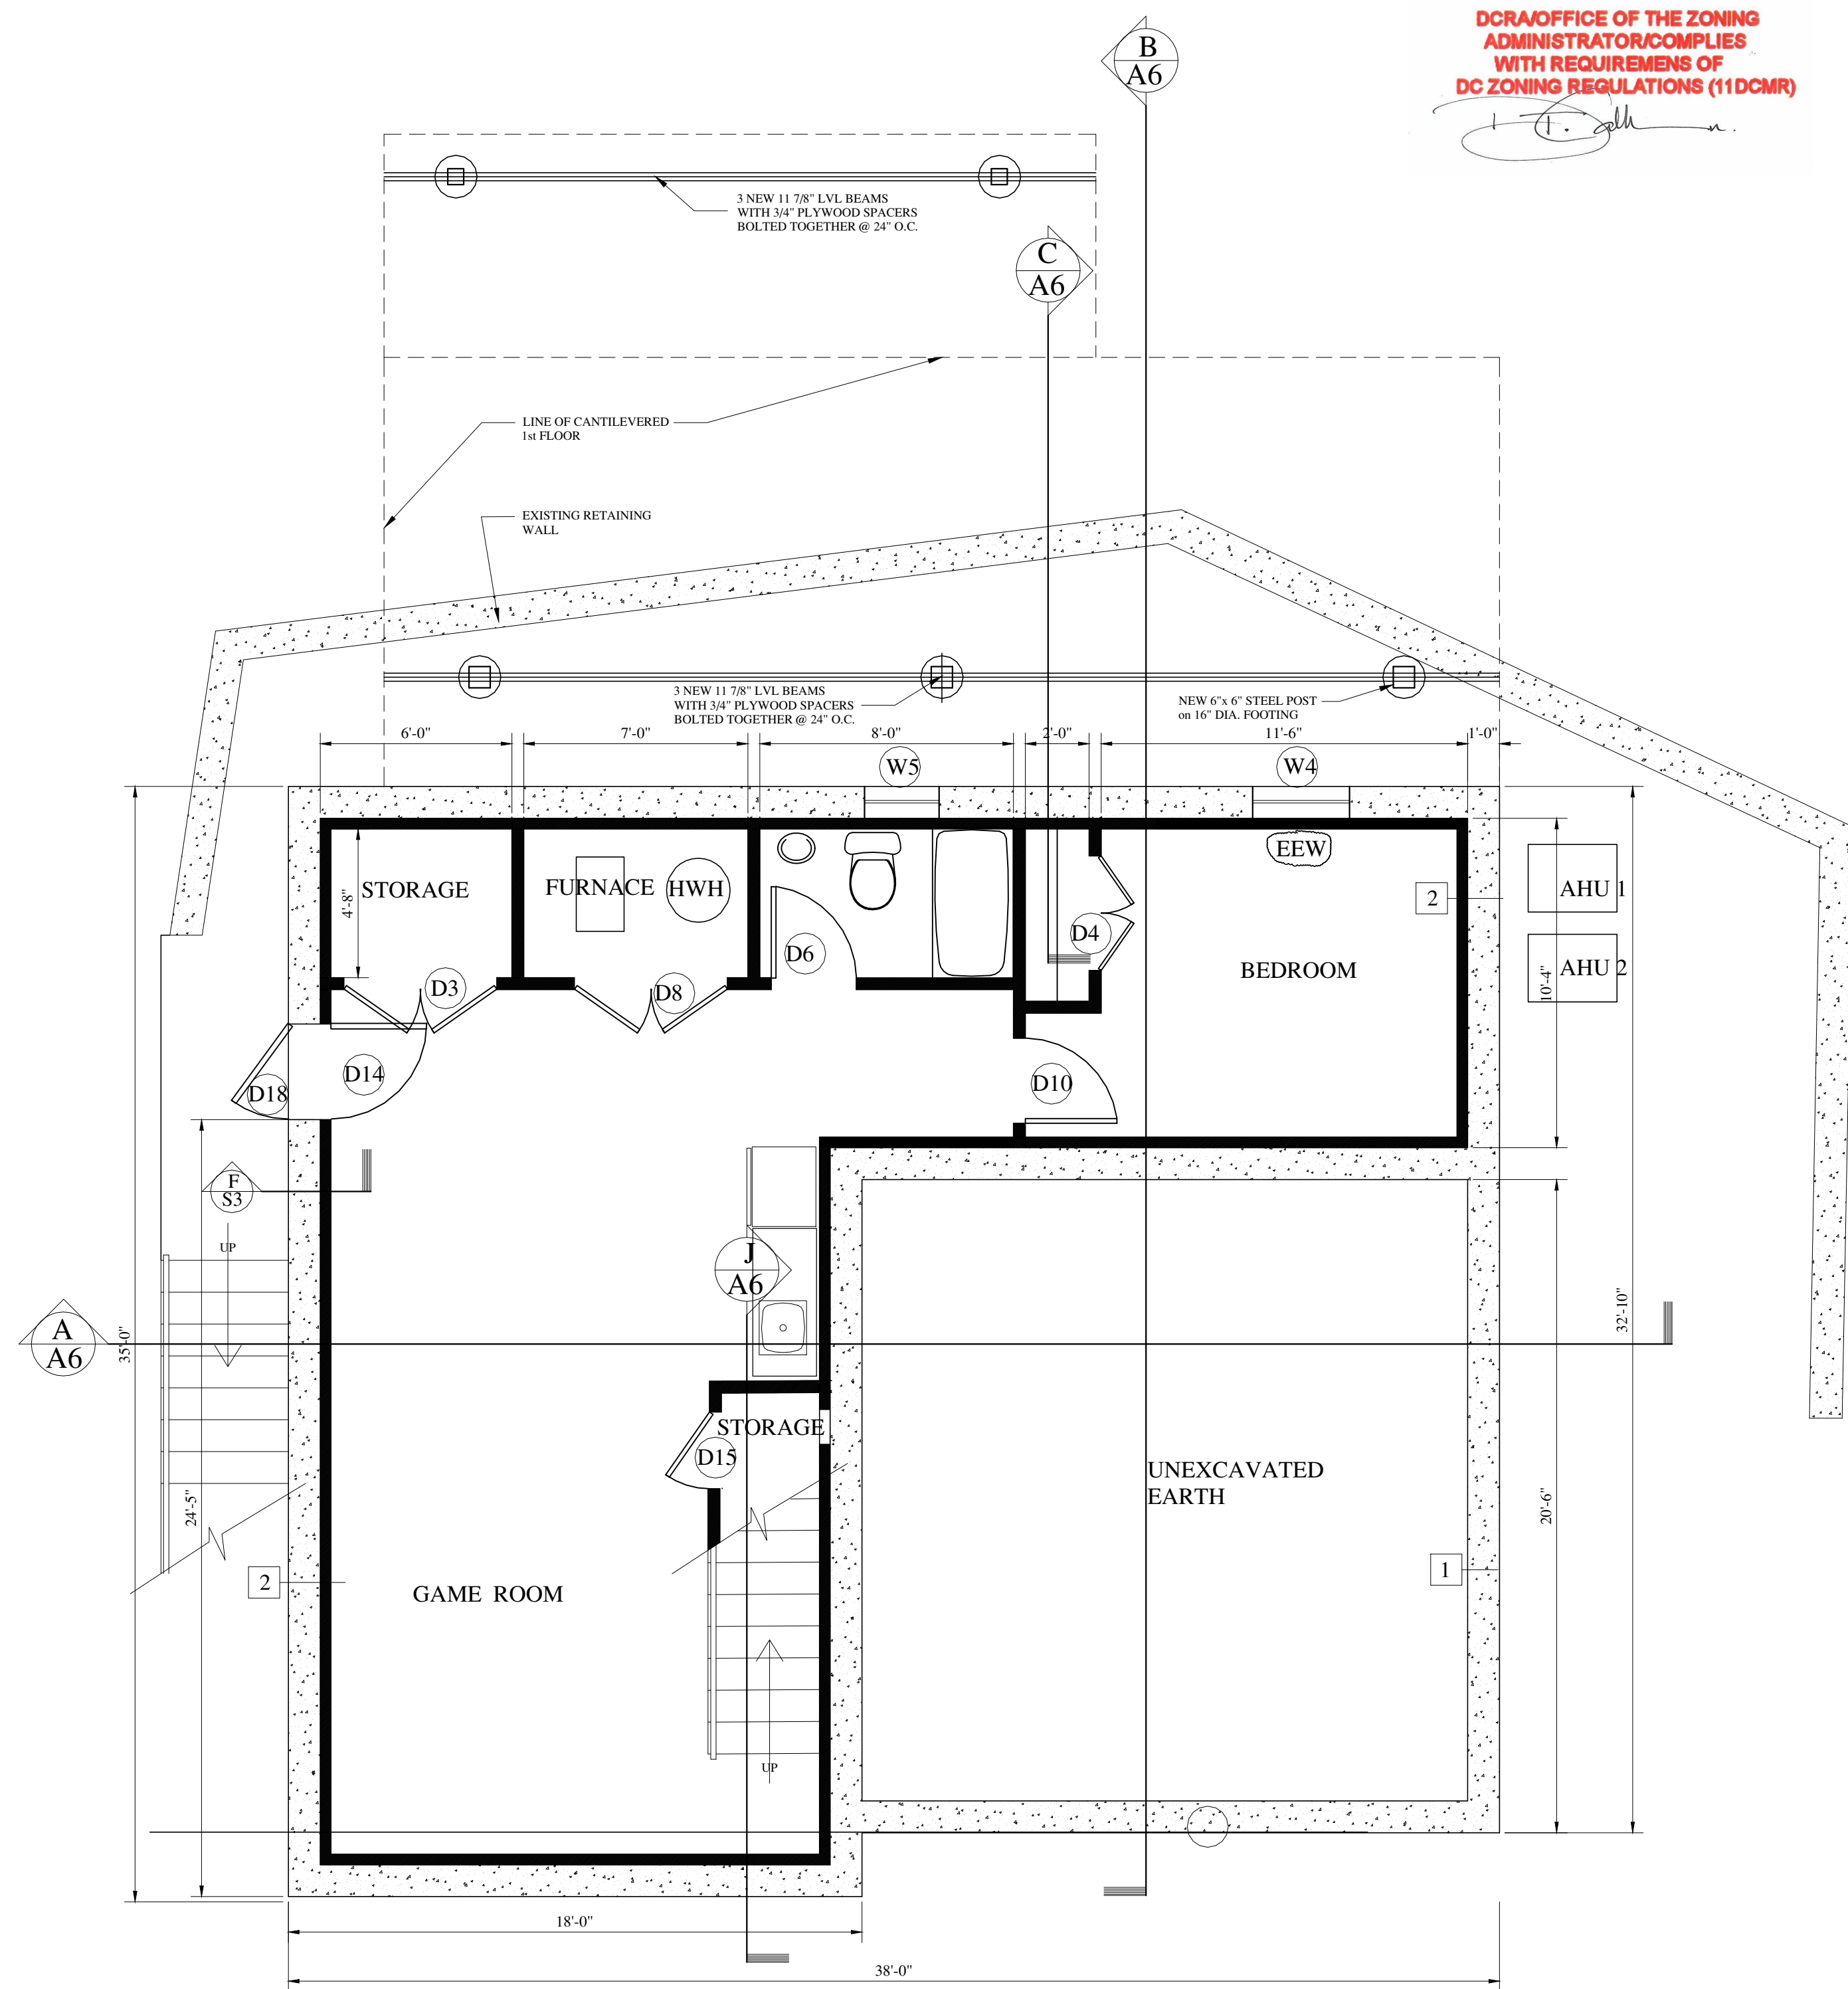

PROPOSED BASEMENT PLAN

SCALE: 1/4" = 1'-0"

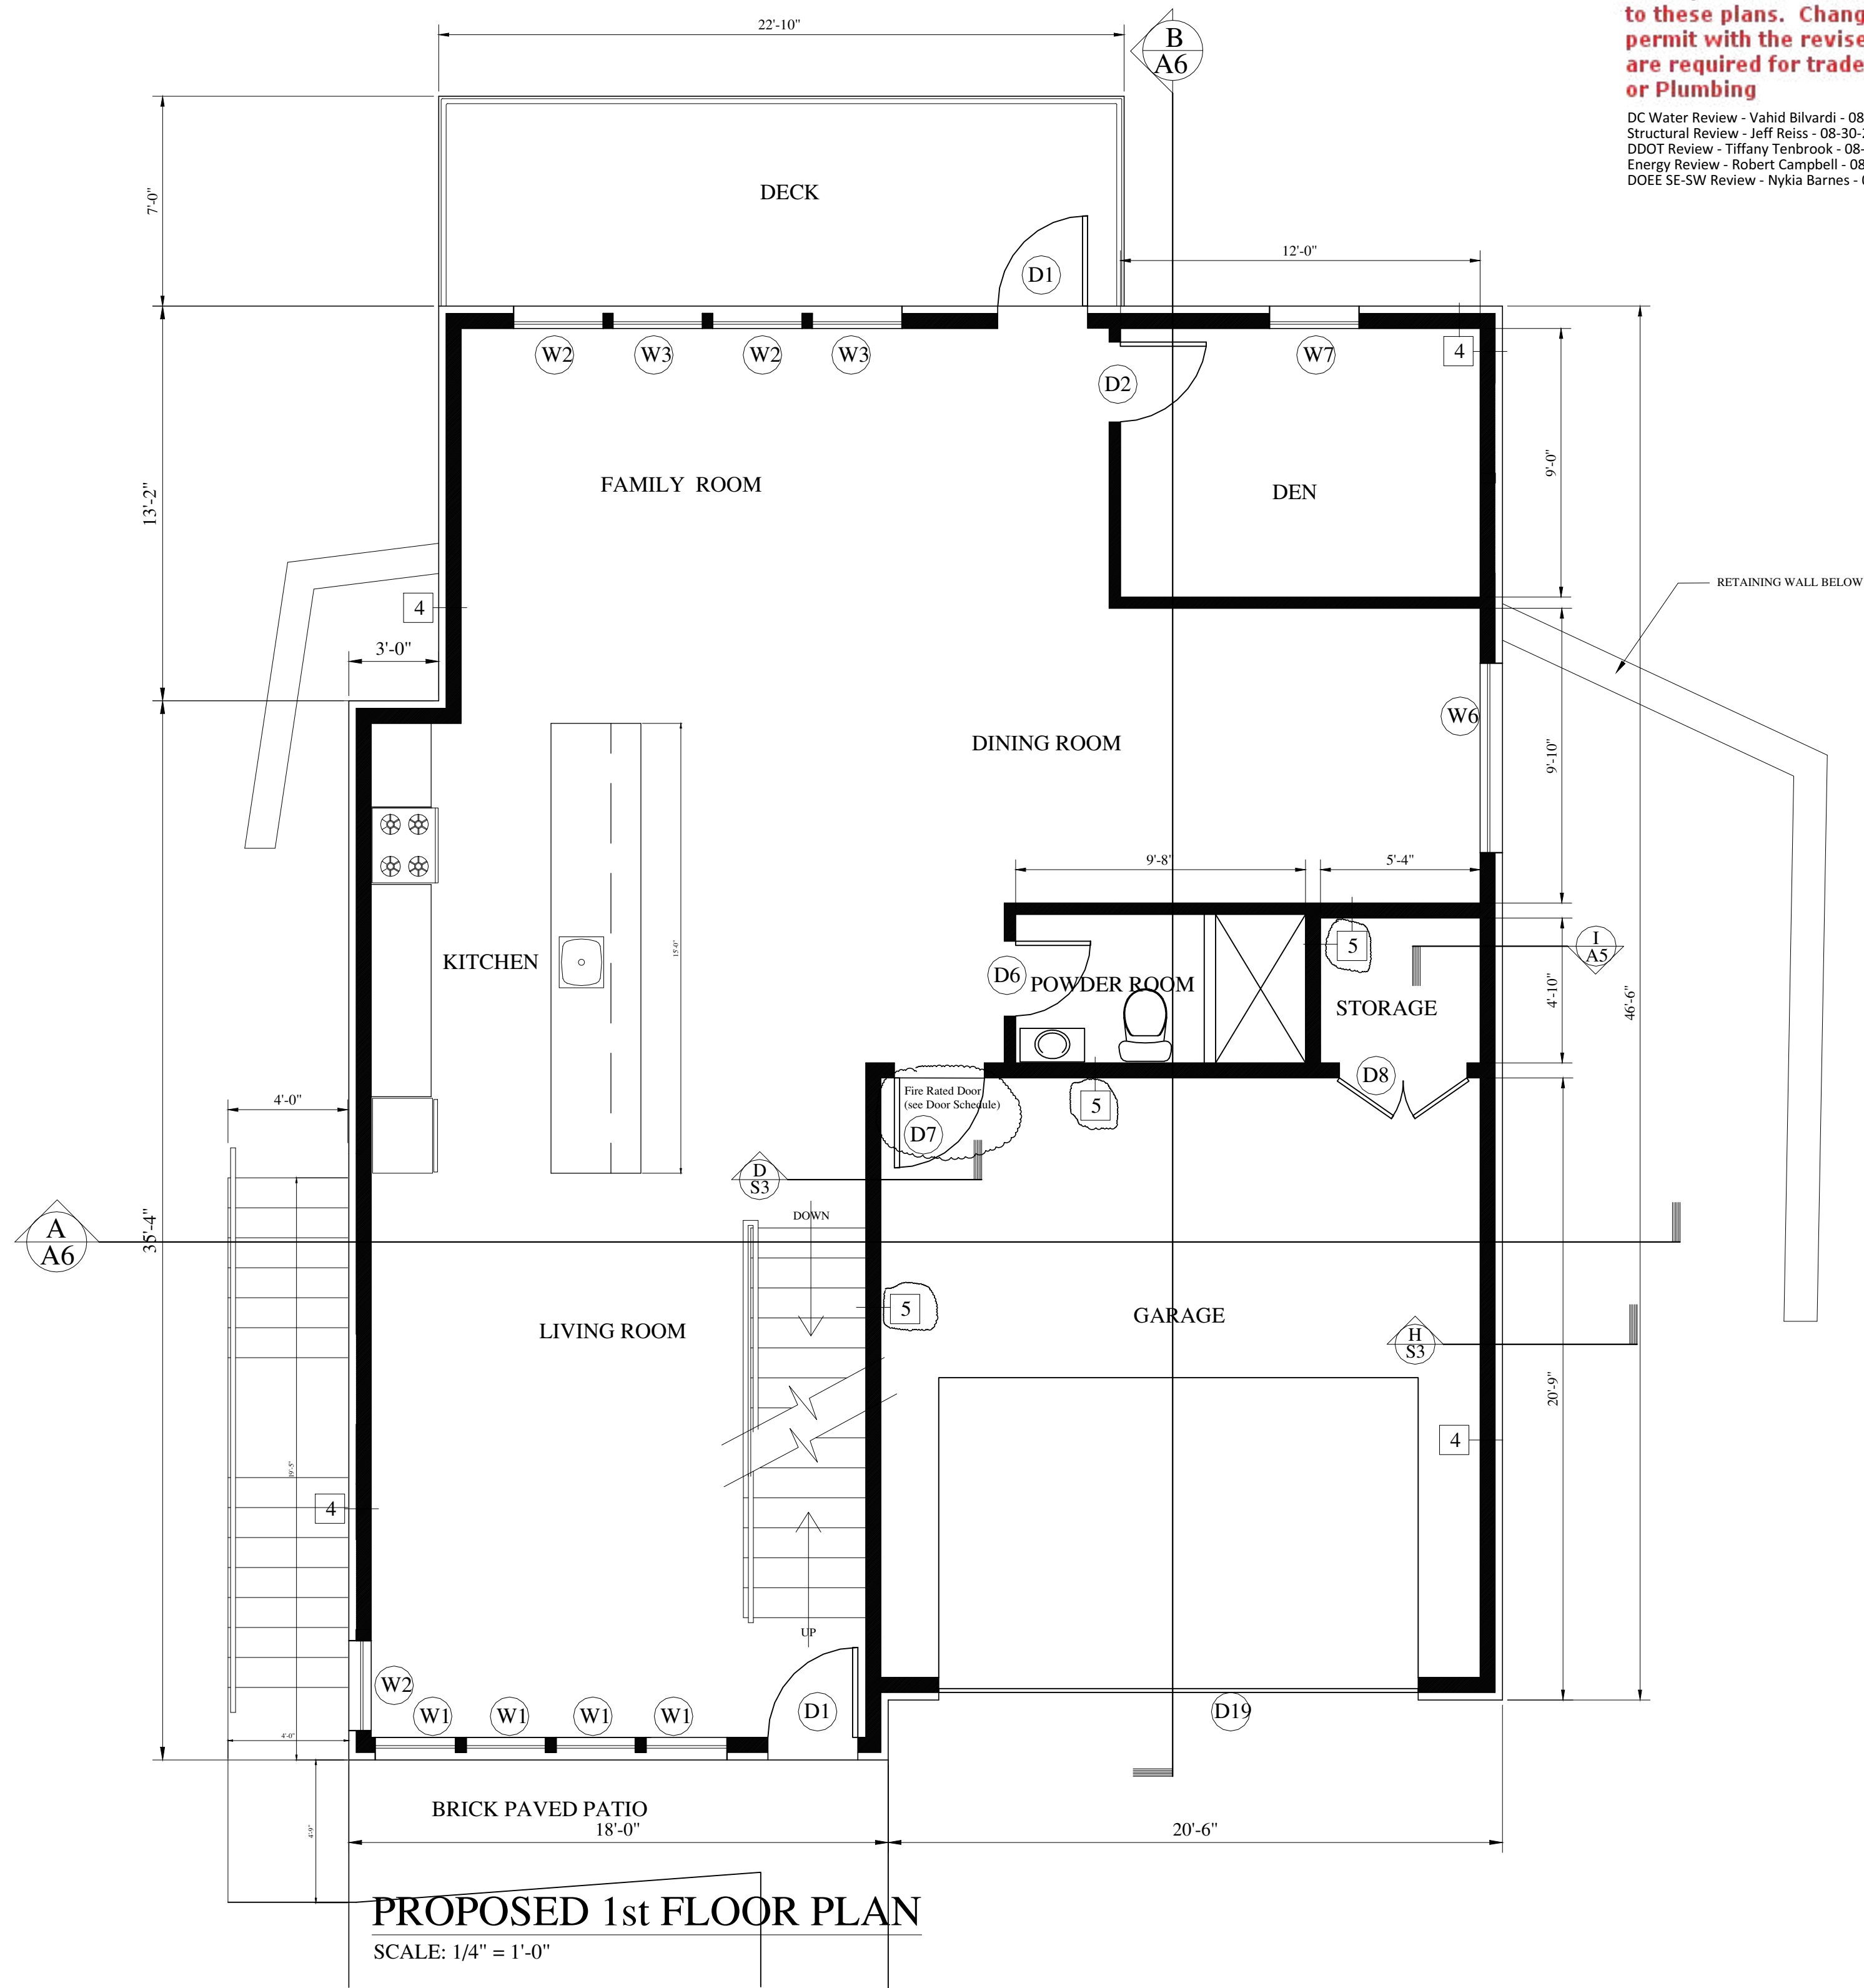

PROPOSED 1st FLOOR PLAN

SCALE: 1/4" = 1'-0"



CAT Consulting Service, LLC.
537 Randolph Street NW
Washington DC 20011
phone 202-829-2252
www.catconsultingservice.com

DATE	12/14/16
DRAWN	CAT
SCALE AS SHOWN	

REVISIONS

PROPOSED BASEMENT, 1st FLOOR PLANS

PROPOSED
2951 Ft. Baker Drive SE
Washington DC 20020

A1

